



QUAD 405 Evolution  
September 2011

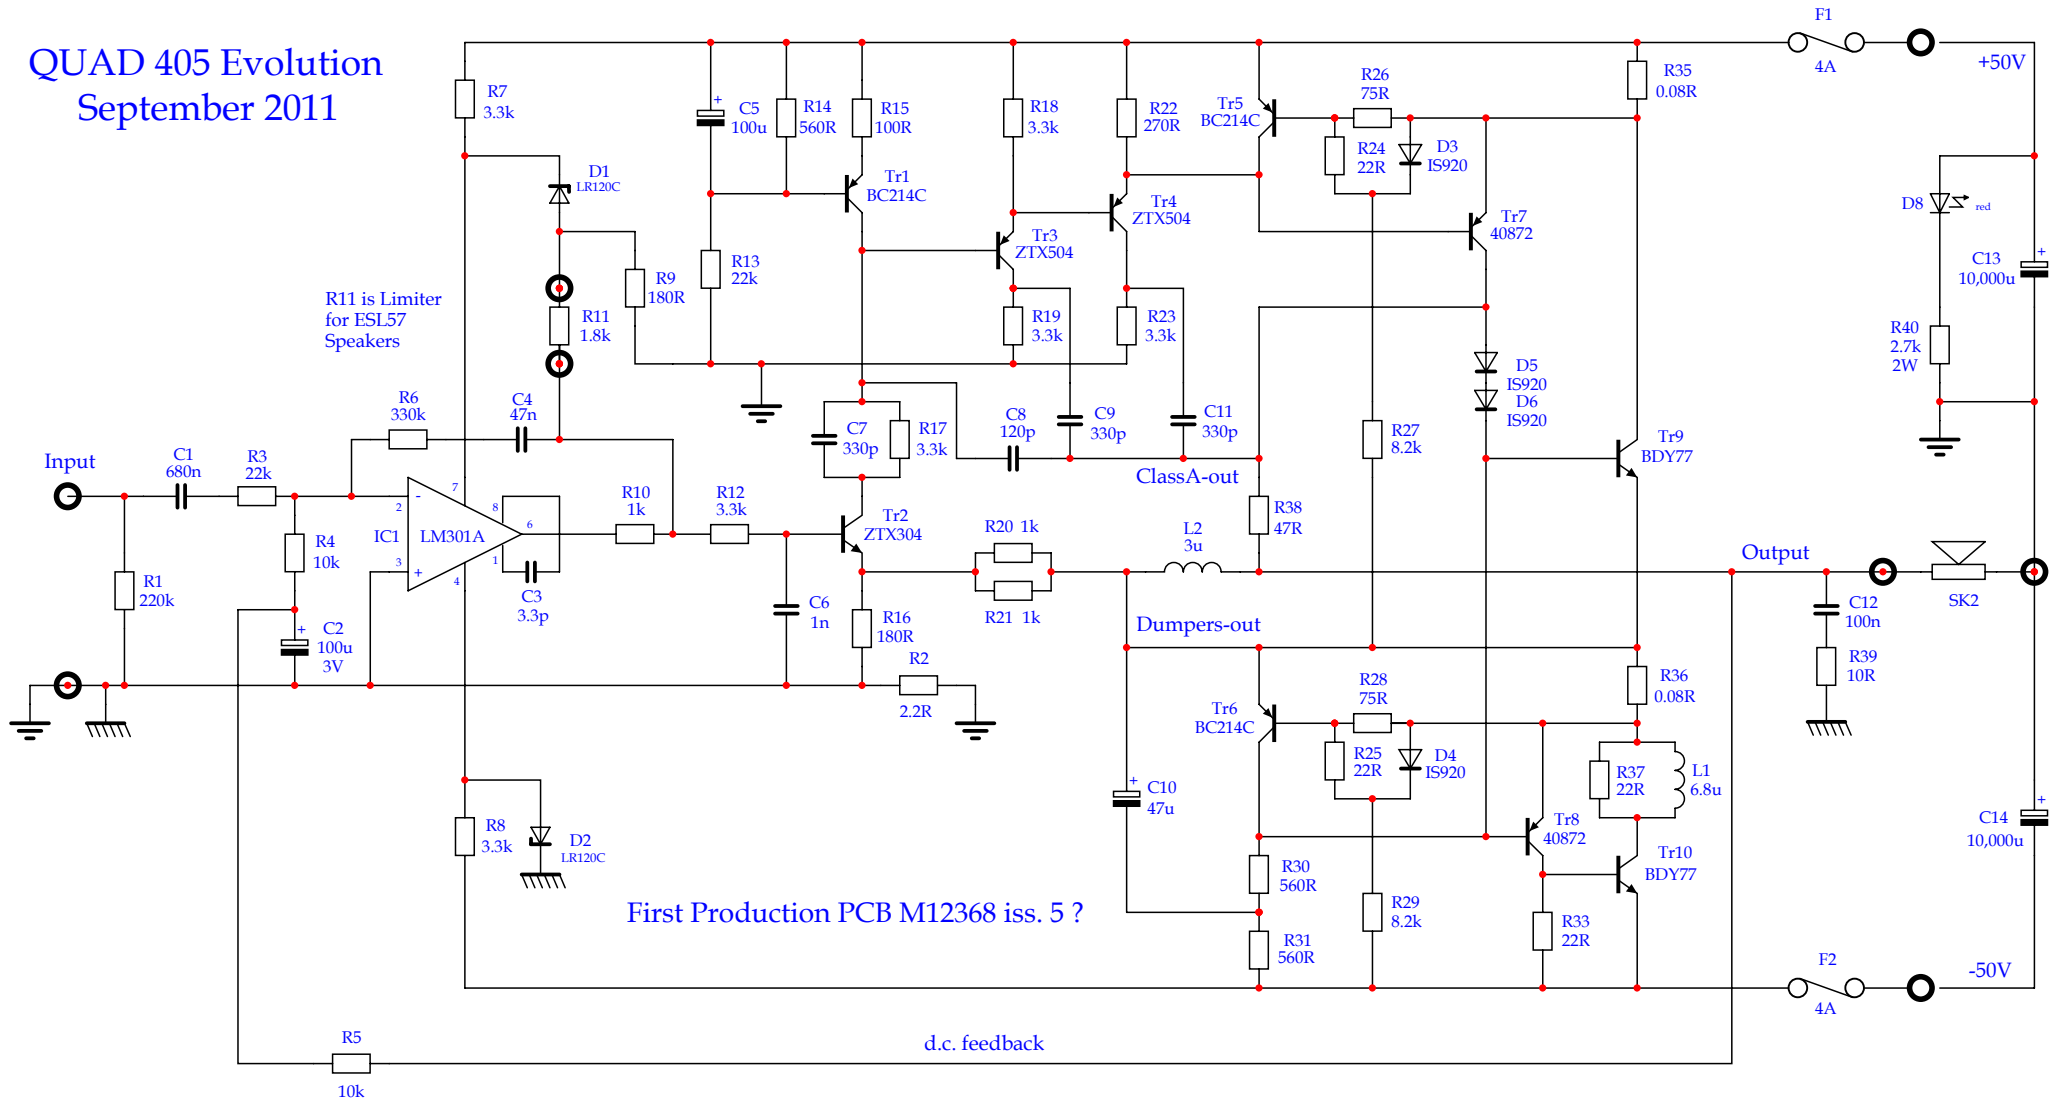


QUAD 405 Schematic as published in Wireless World Dec.1975  
to support the article "Current Dumping Audio Amplifier"  
by P J Walker of the Acoustic Manufacturing Co. Ltd. (Q.U.A.D.)

Revision: 2	keith@snook.eu	Page Size: A4
<b>QUAD 405 M12333 iss. 2</b>		
2 Mar 2002	Drawn: K. Snook	Checked:
		Page 1 of 1

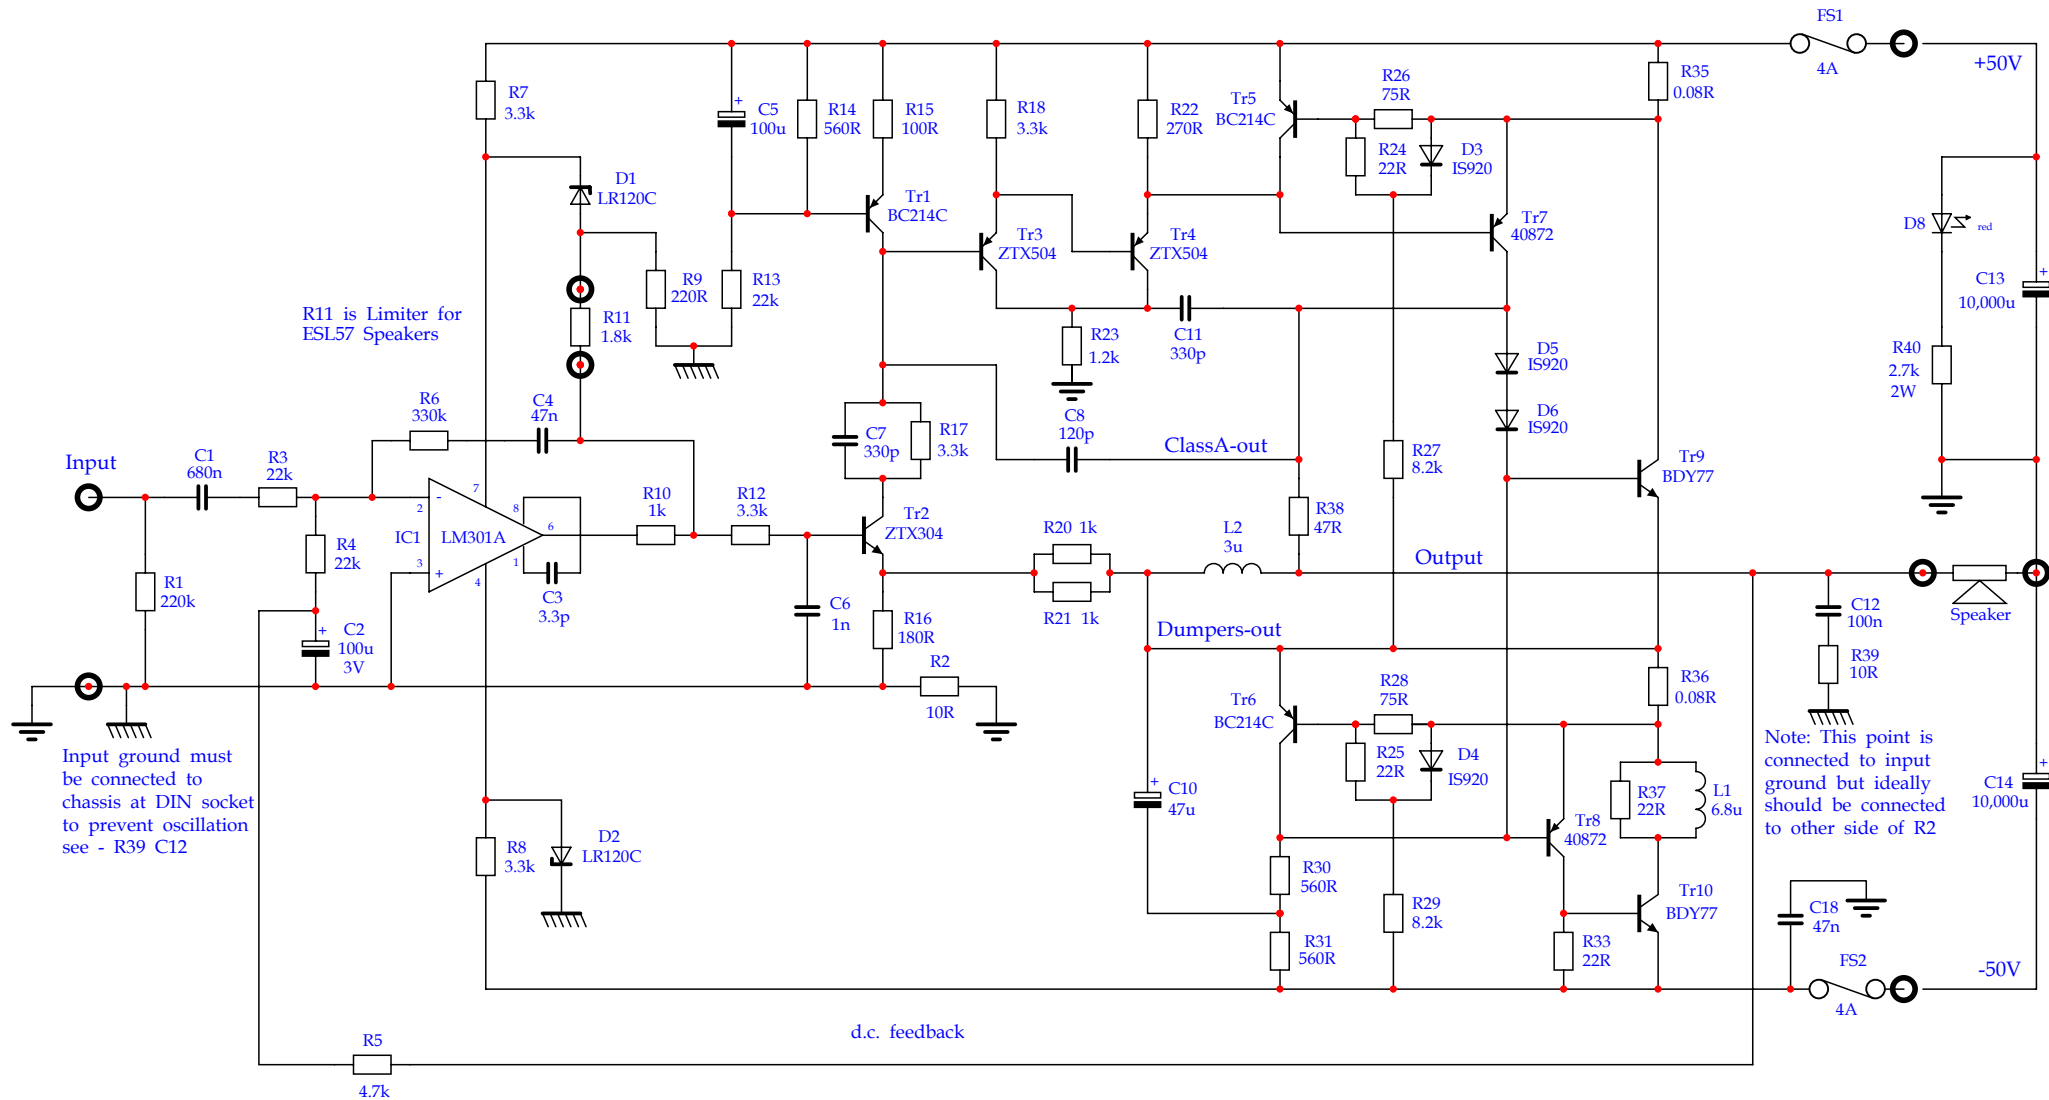


M12368 iss. 7 PCBs were used for serial numbers from ?? to 9000

Revision: 1	keith@snook.eu	Page Size: A4
<b>QUAD 405 - M12333 iss. 3</b>		
8 Feb 2003	Drawn: K. Snook	Checked:
		Page 1 of 1

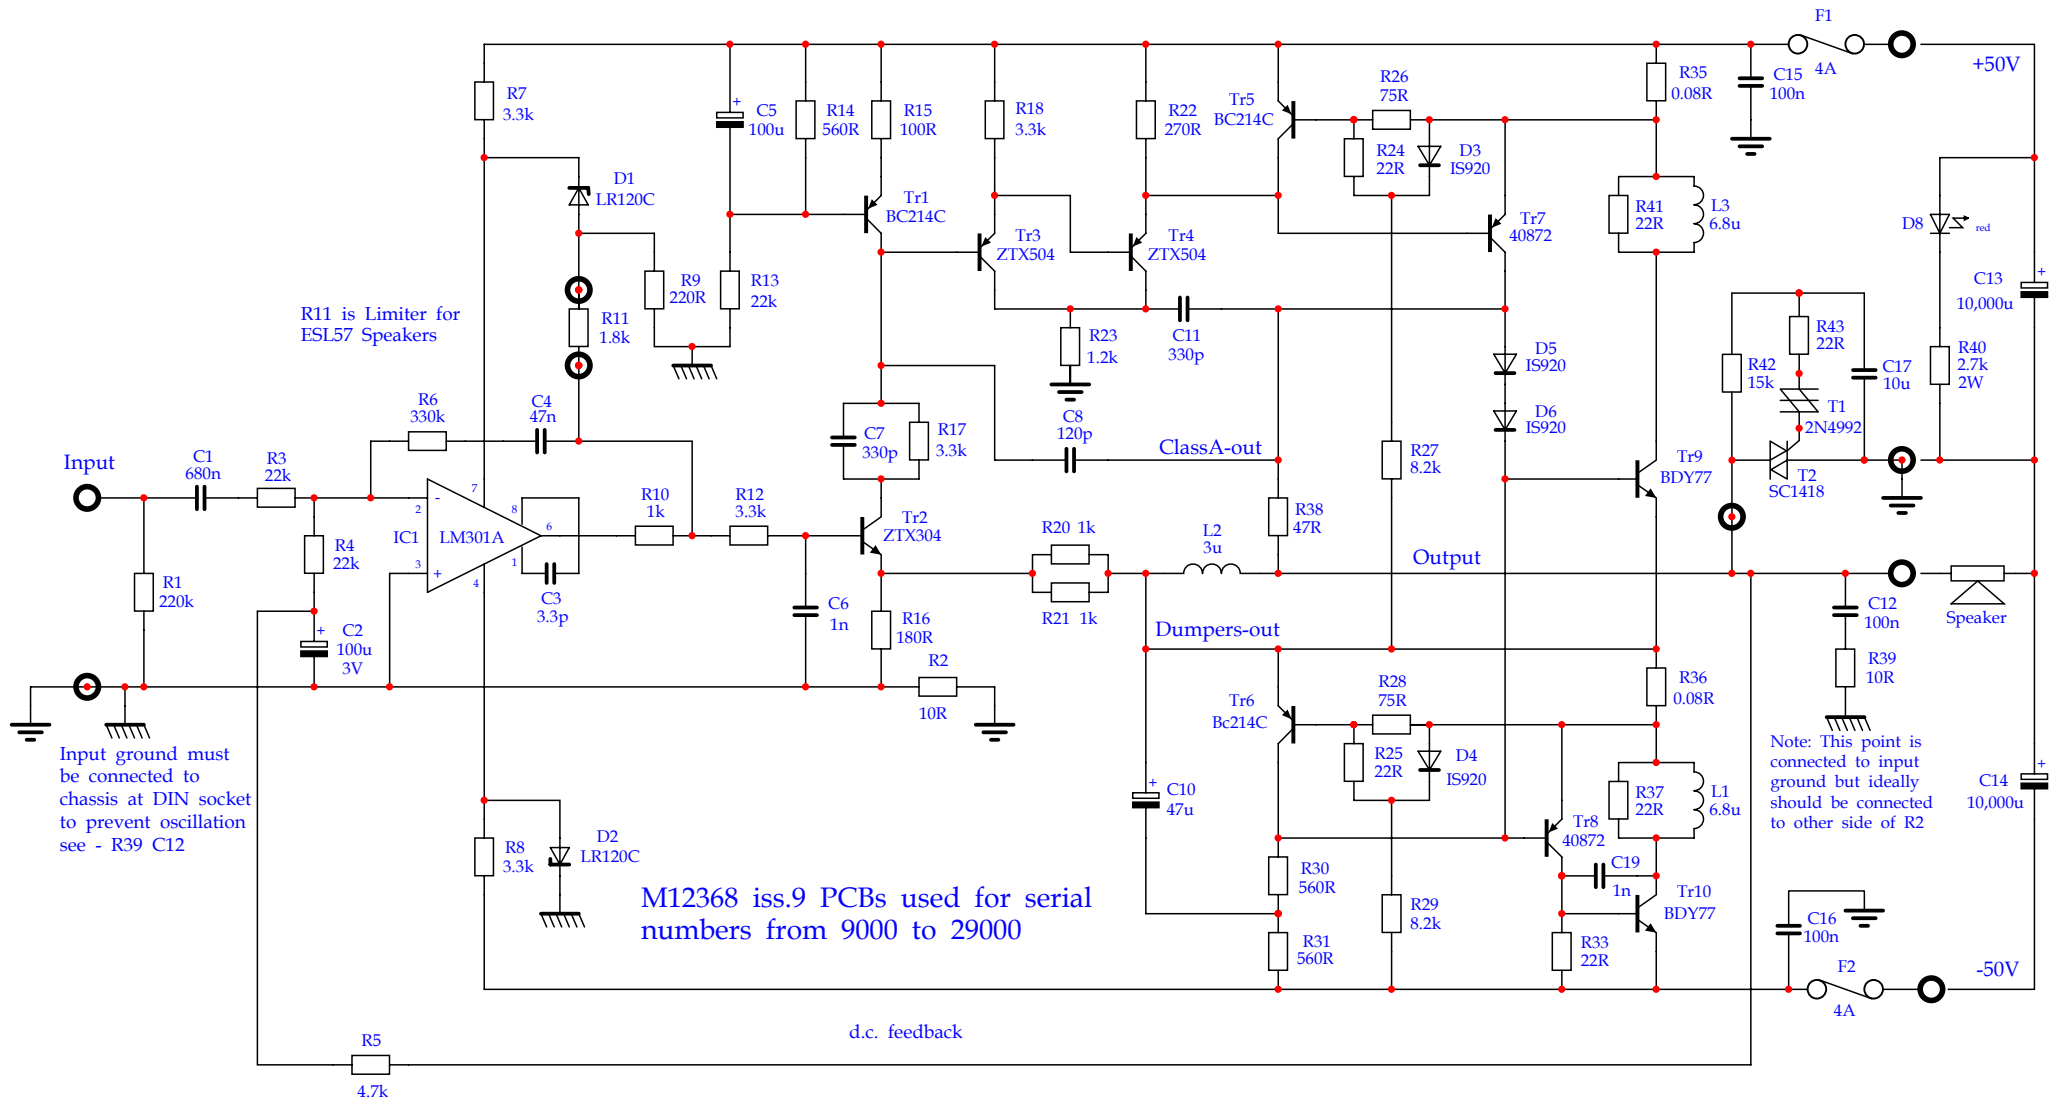

Revision: 2	keith@snook.eu	Page Size: A4
<b>QUAD 405 - M12333 iss. 4</b>		
8 Feb 2003	Drawn: K. Snook	Checked:
		Page 1 of 1

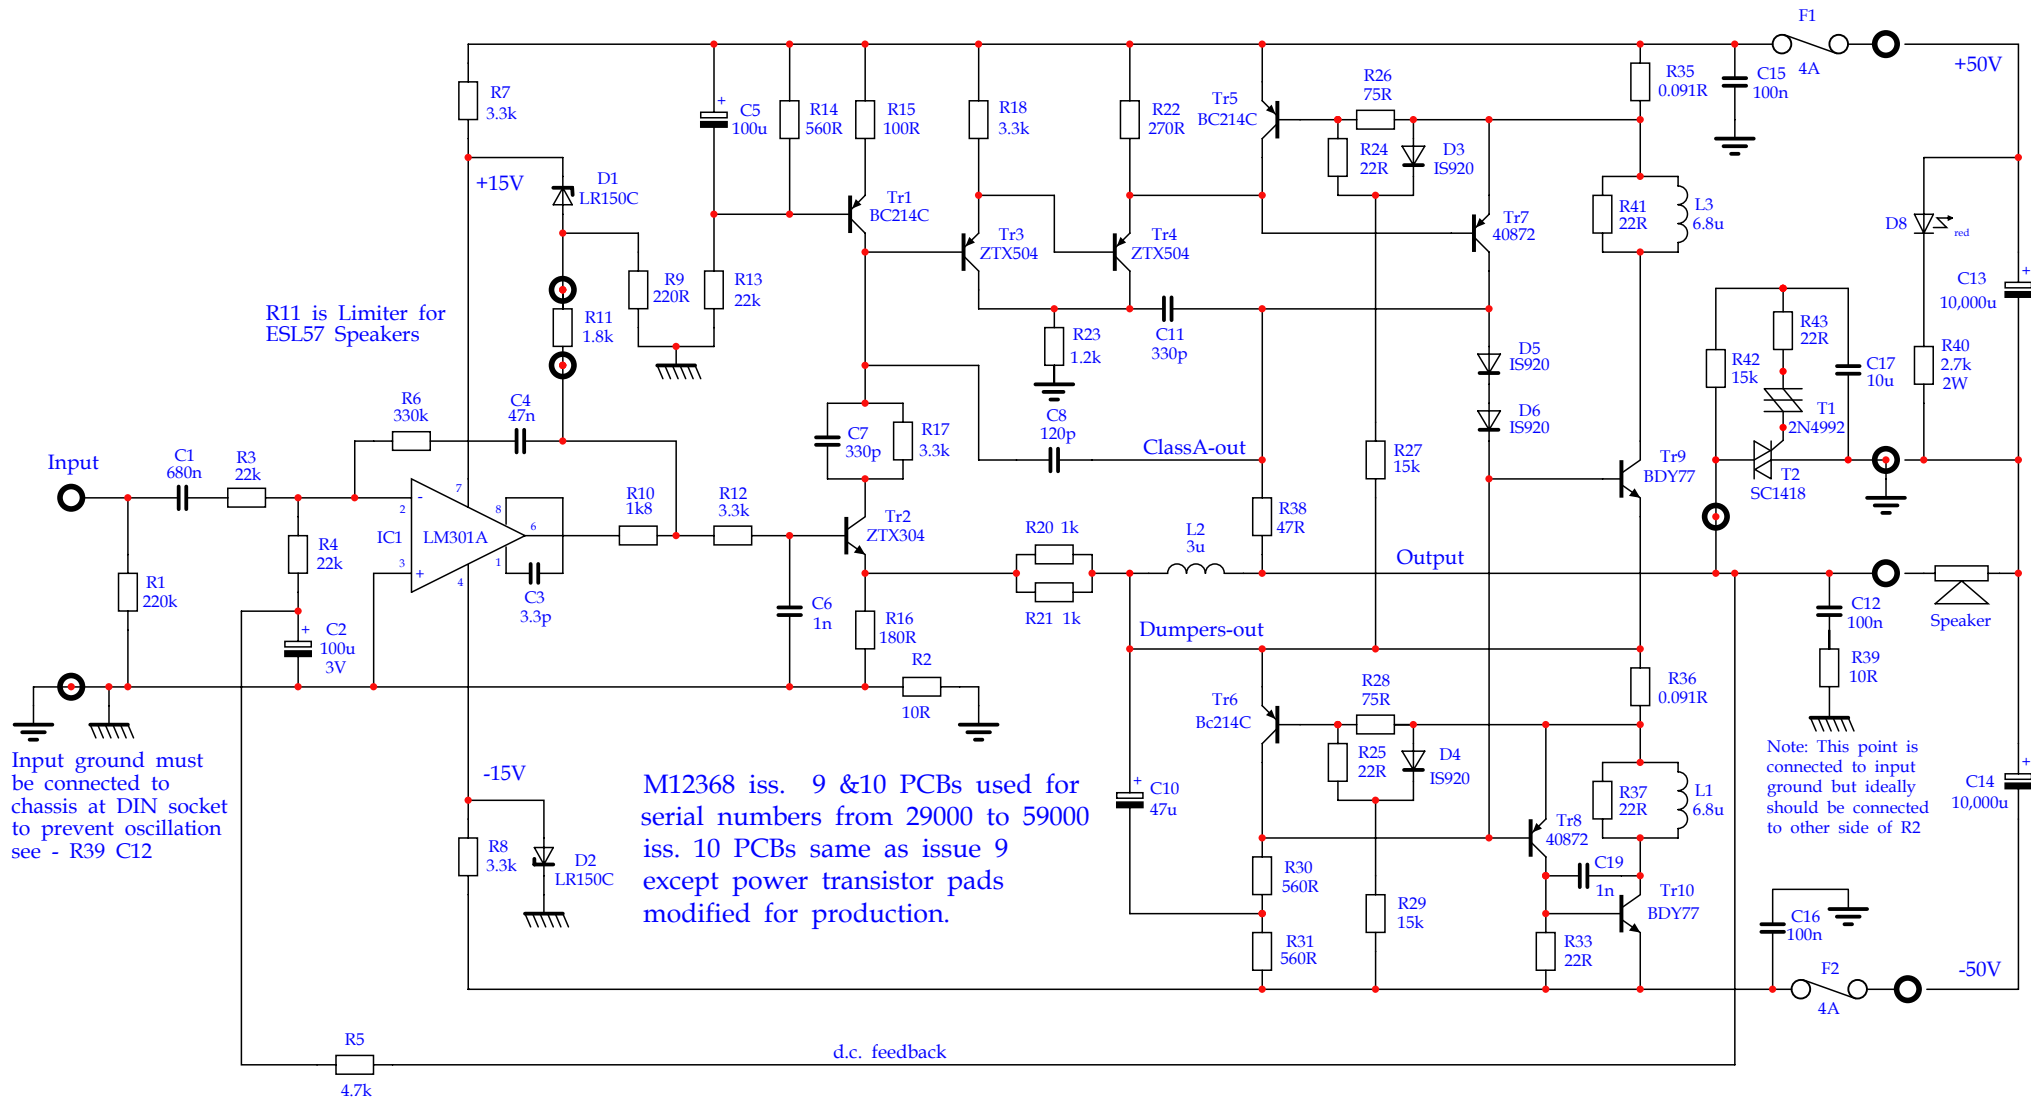


Input ground must be connected to chassis at DIN socket to prevent oscillation see - R39 C12

R11 is Limiter for ESL57 Speakers


M12368 iss. 9 & 10 PCBs used for serial numbers from 29000 to 59000  
 iss. 10 PCBs same as issue 9 except power transistor pads modified for production.

Note: This point is connected to input ground but ideally should be connected to other side of R2


Revision: 2	keith@snook.eu	Page Size:A4
<b>QUAD 405 - M12333 iss. 5</b>		
8 Feb 2003	Drawn: K. Snook	Checked:
		Page 1 of 1

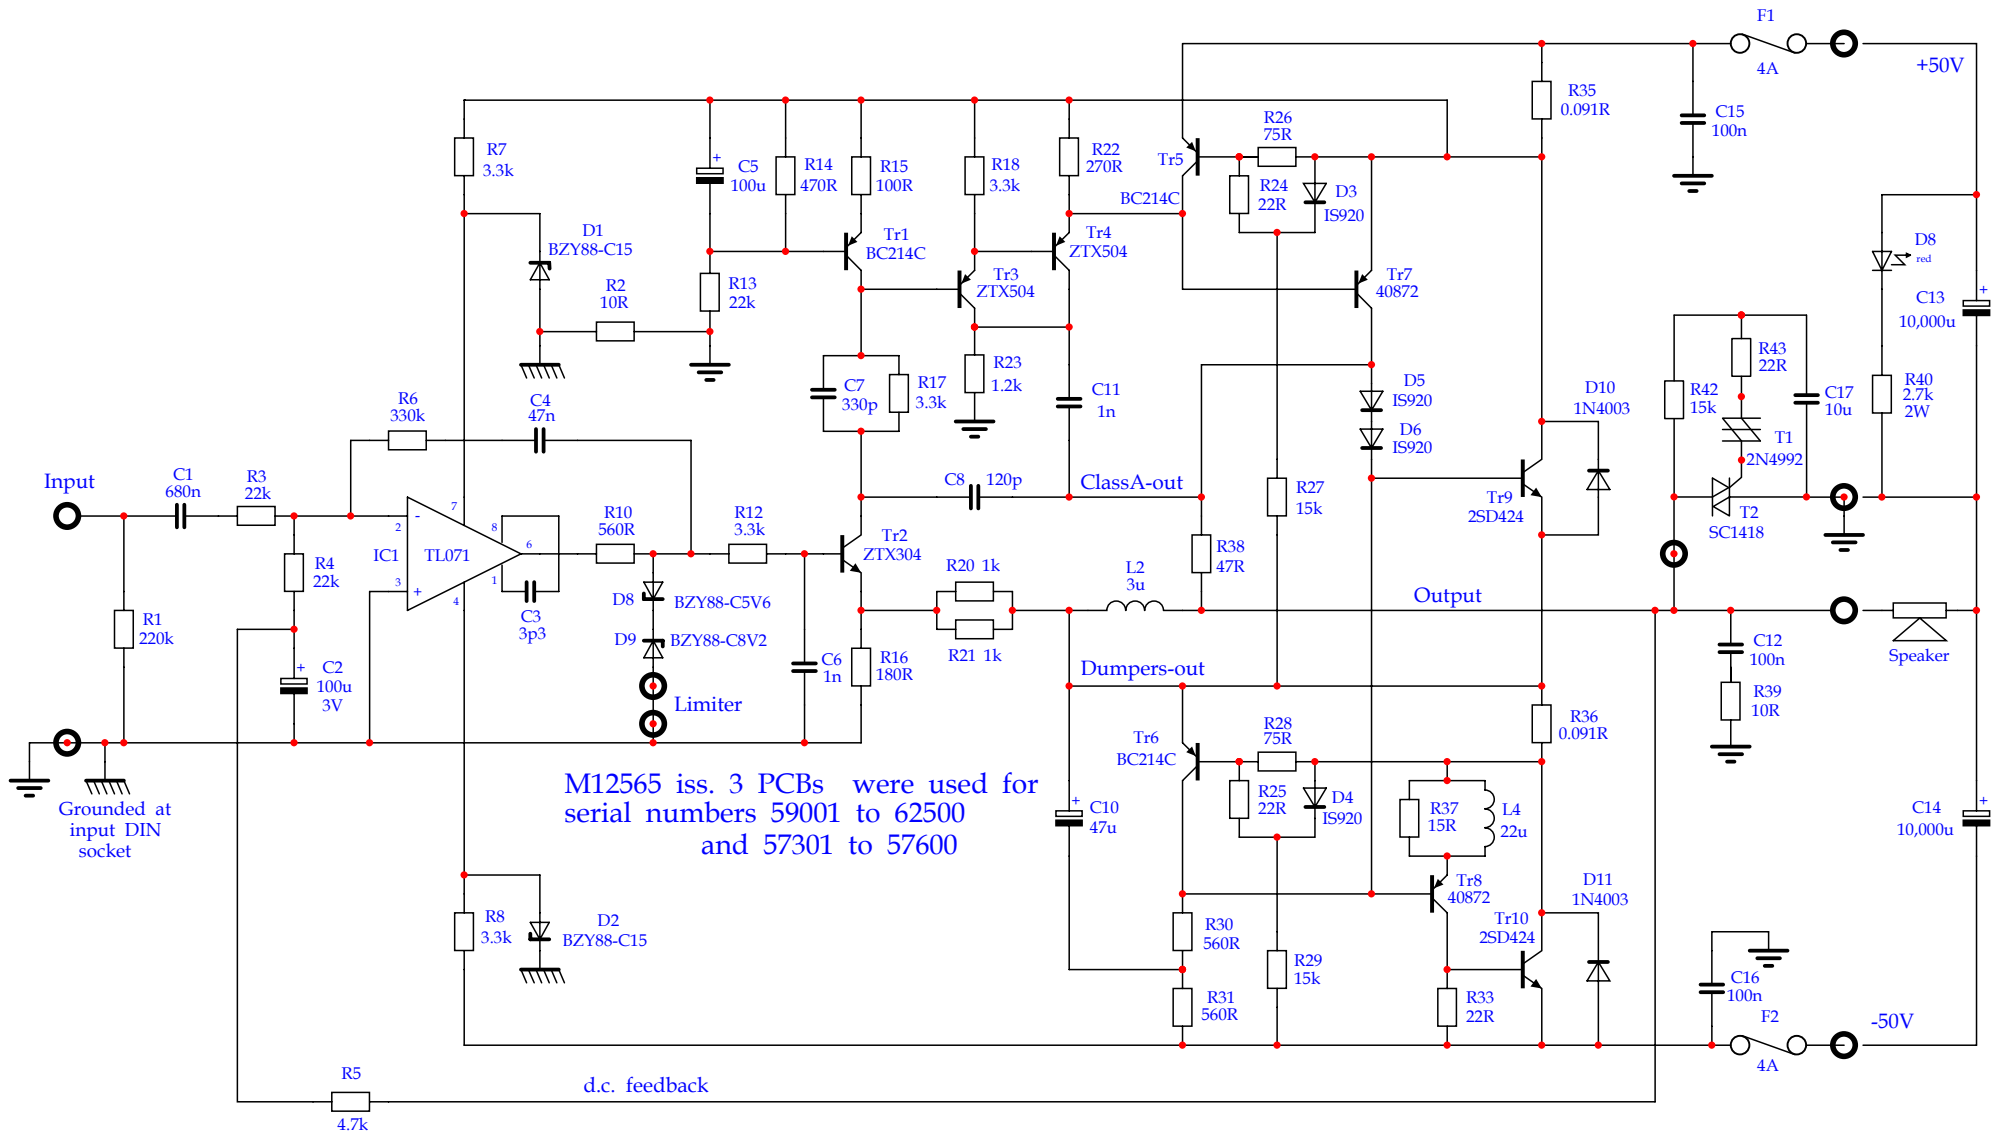


Revision: 2	keith@snook.eu	Page Size: A4
<b>QUAD 405 - M12333 iss. 6</b>		
4	0Drawn: hK.cSnook	Checked: M
		Page 1 of 1

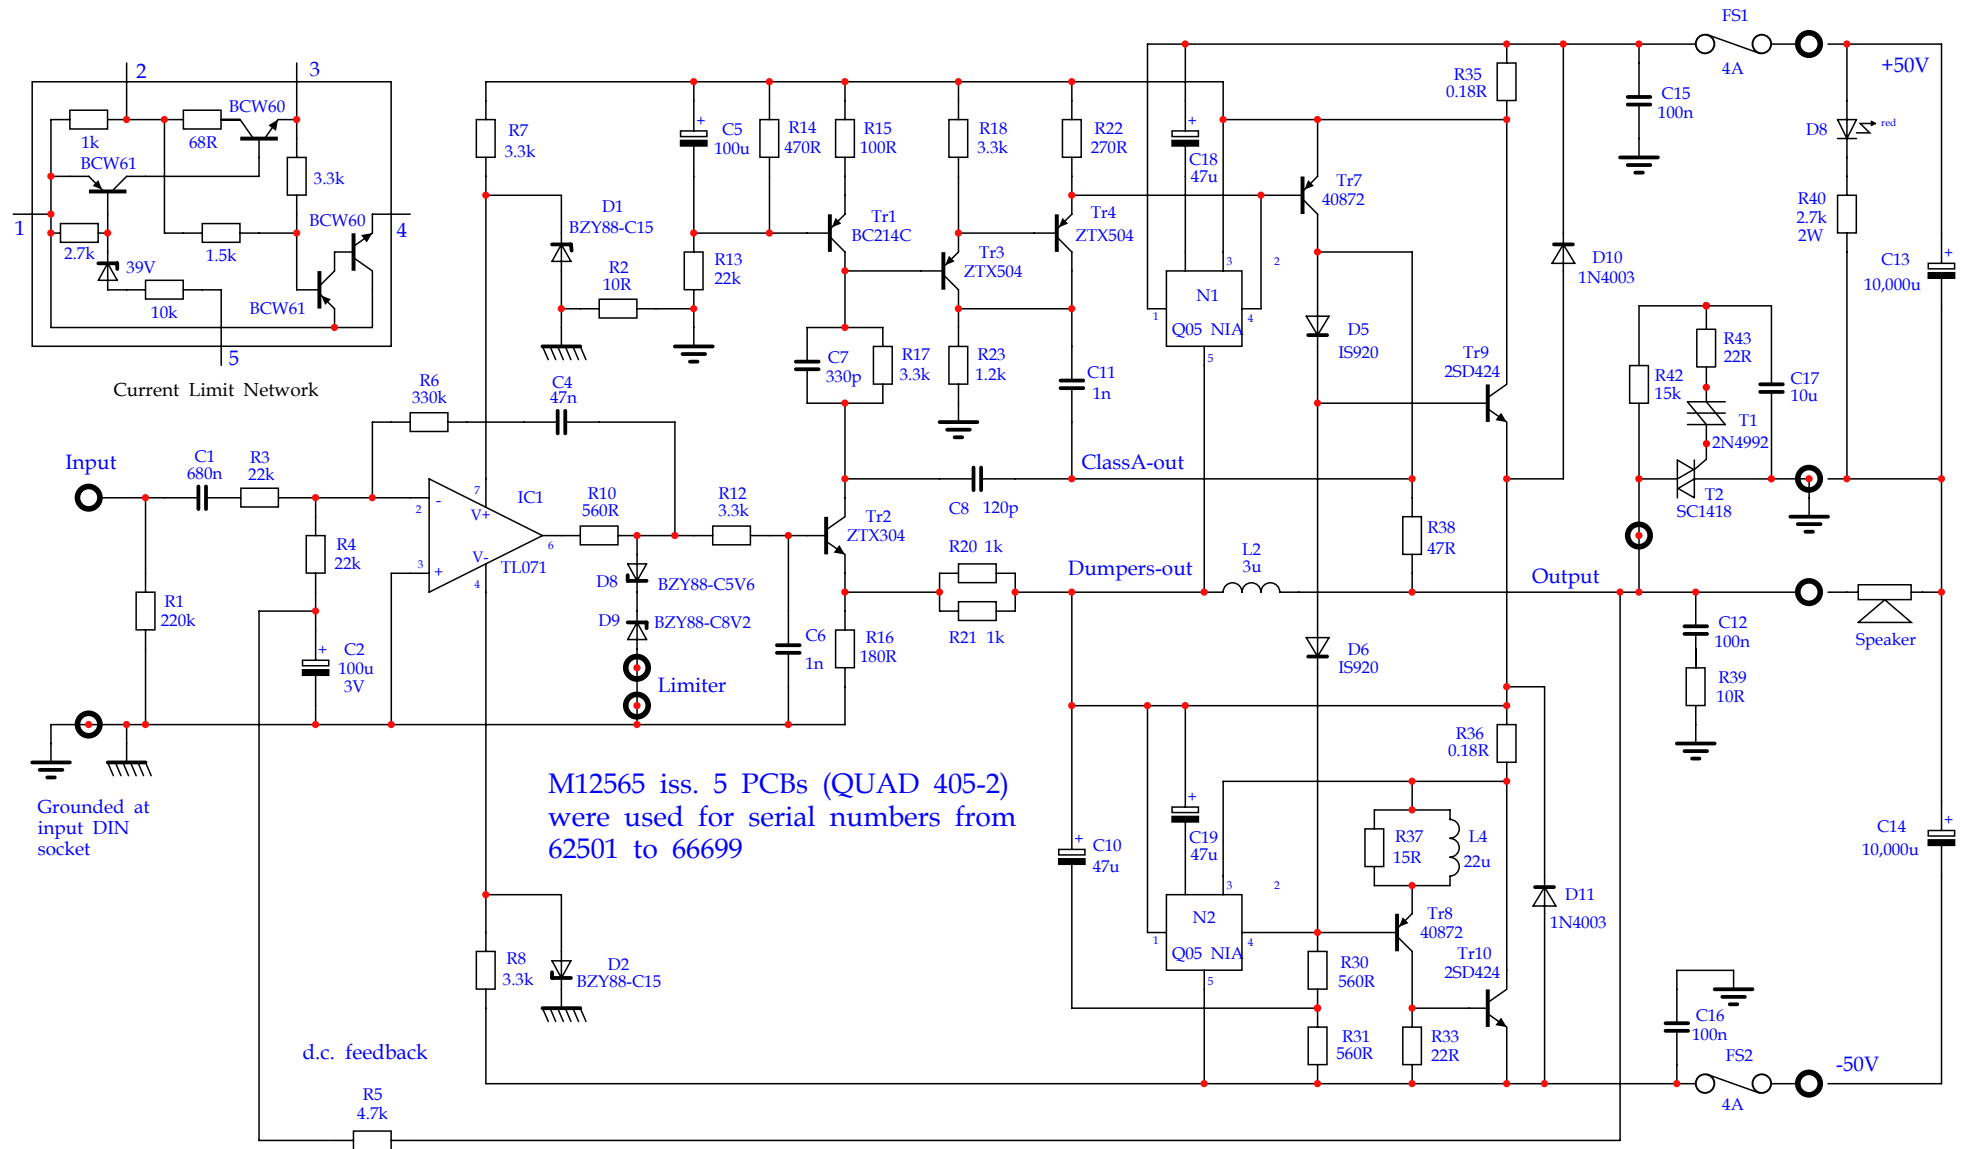

Revision: 1	keith@snook.eu	Page Size: A4
<b>QUAD 405 - M12333 iss. 7</b>		
8 Feb 2003	Drawn: K. Snook	Checked:
		Page 1 of 1

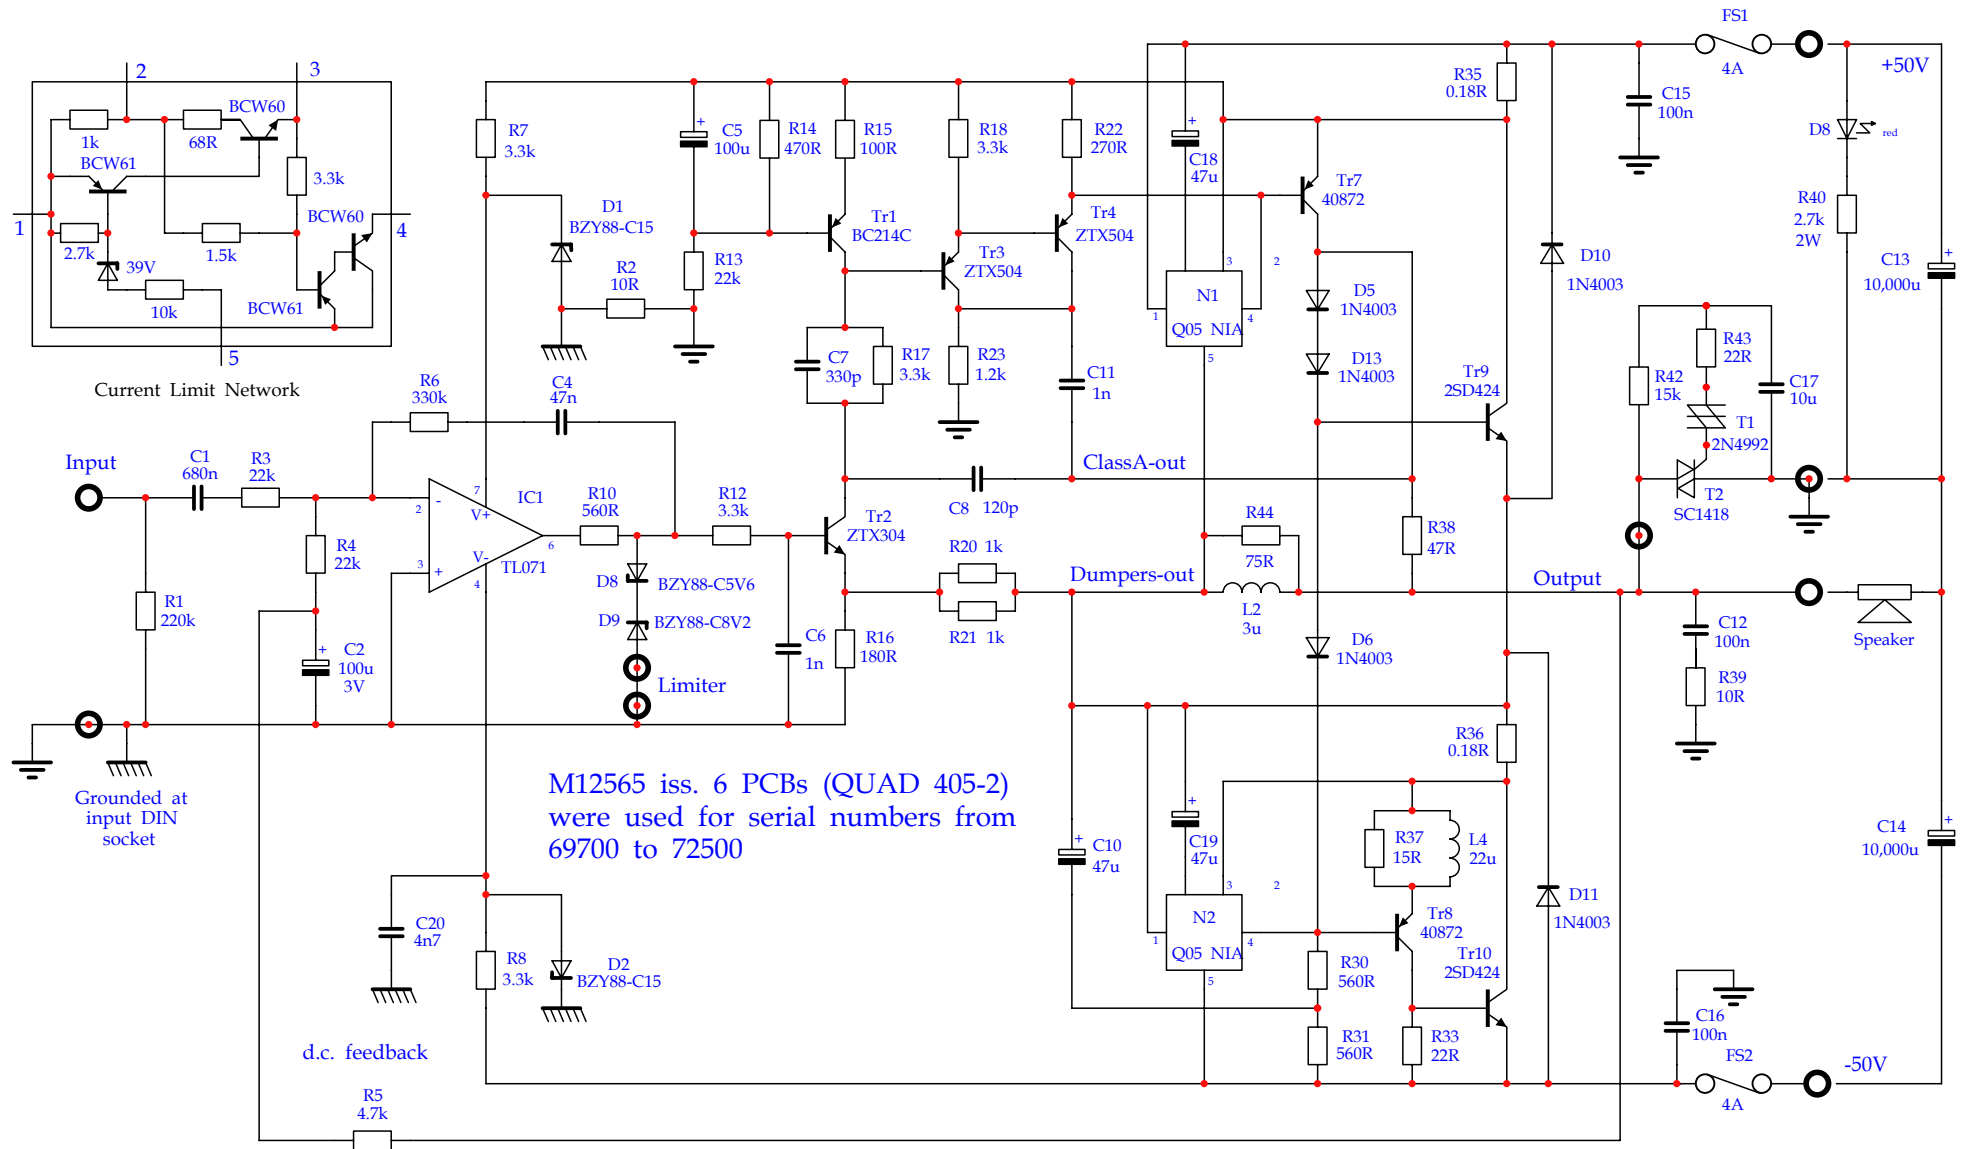


Revision: 1	keith@snook.eu	Page Size: A4
<b>QUAD 405 - M12333 iss. 8</b>		
8 Feb 2003	Drawn: K. Snook	Checked:
		Page 1 of 1

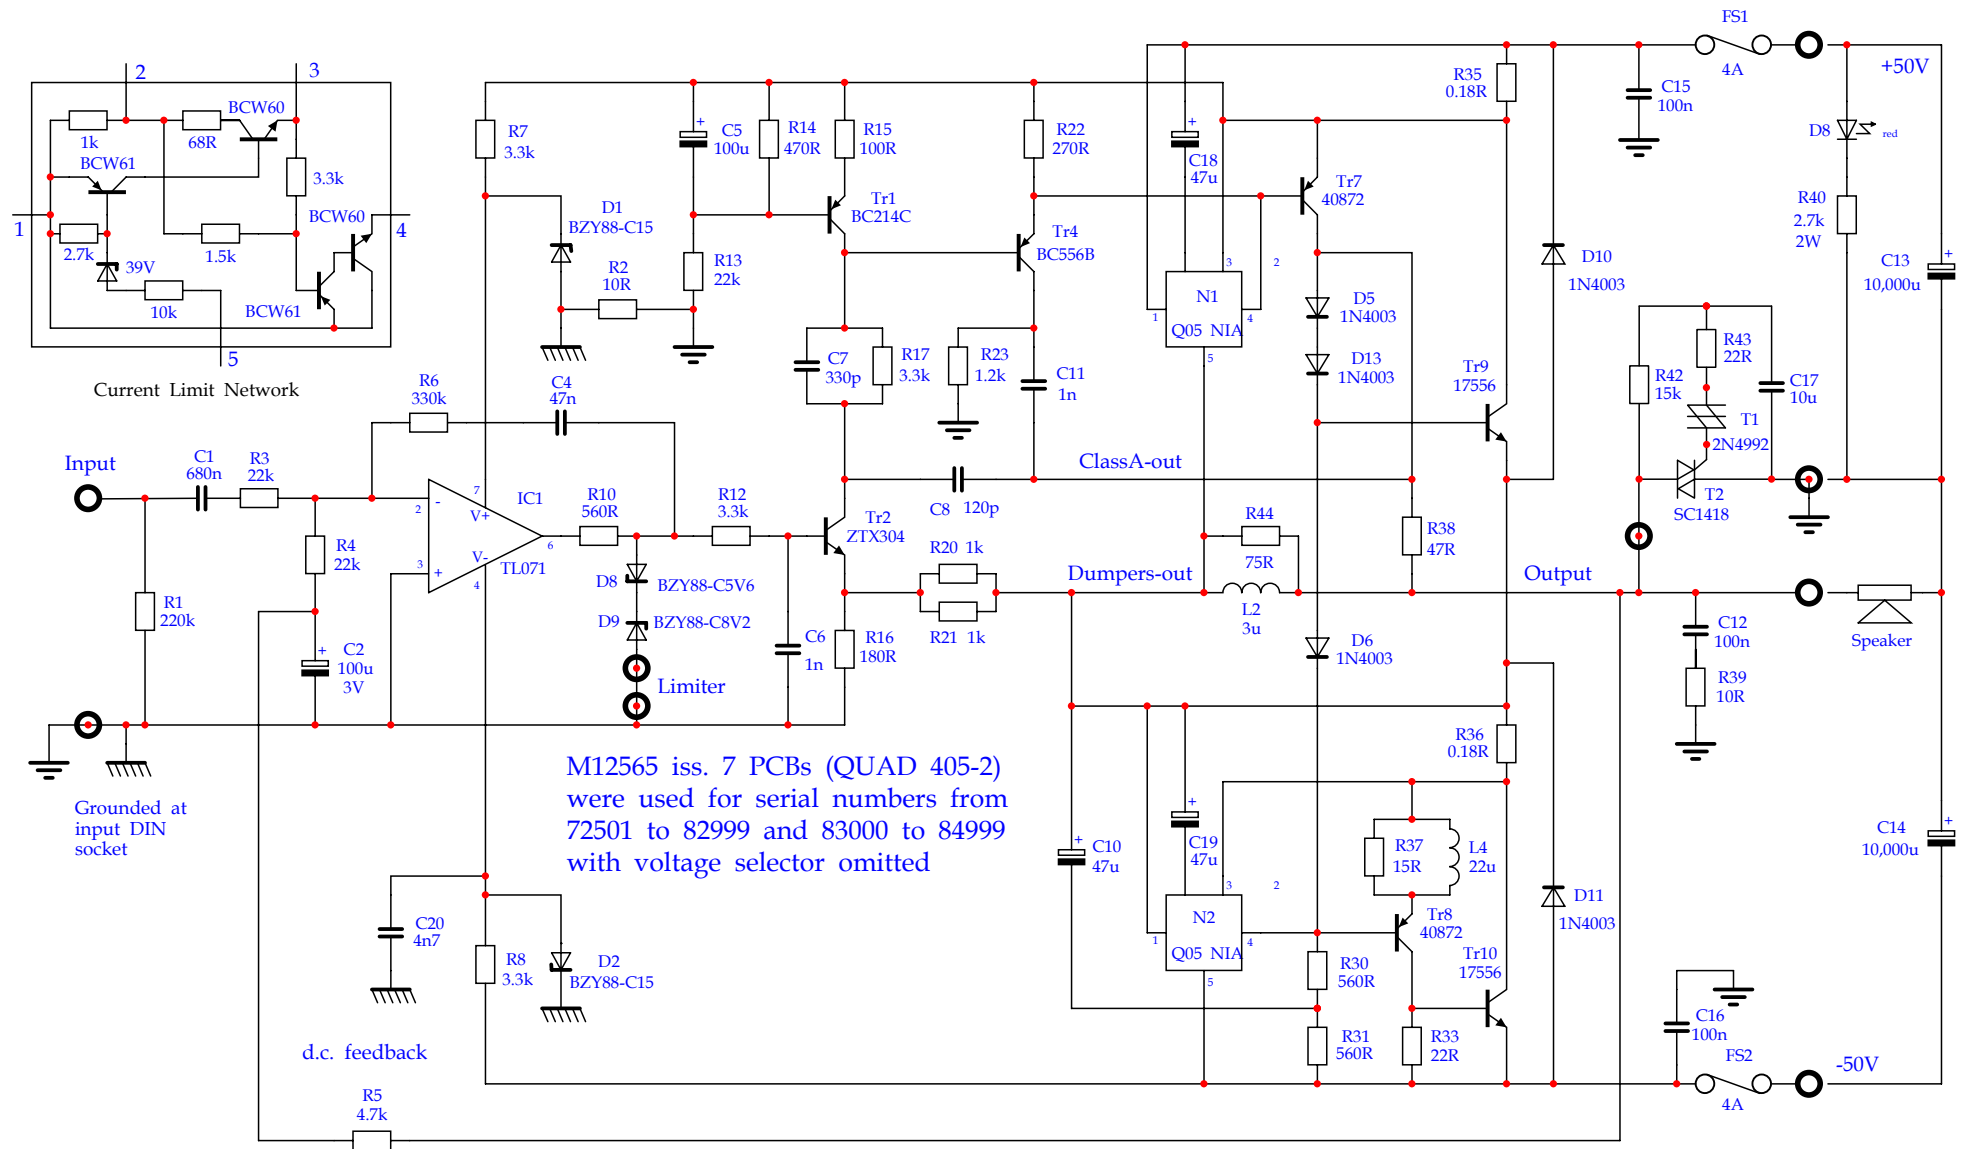


Revision: 1	keith@snook.eu	Page Size: A4
<b>QUAD 405 - M12333 iss. 9</b>		
12 Feb 2003	Drawn: K. Snook	Checked:
		Page 1of 1



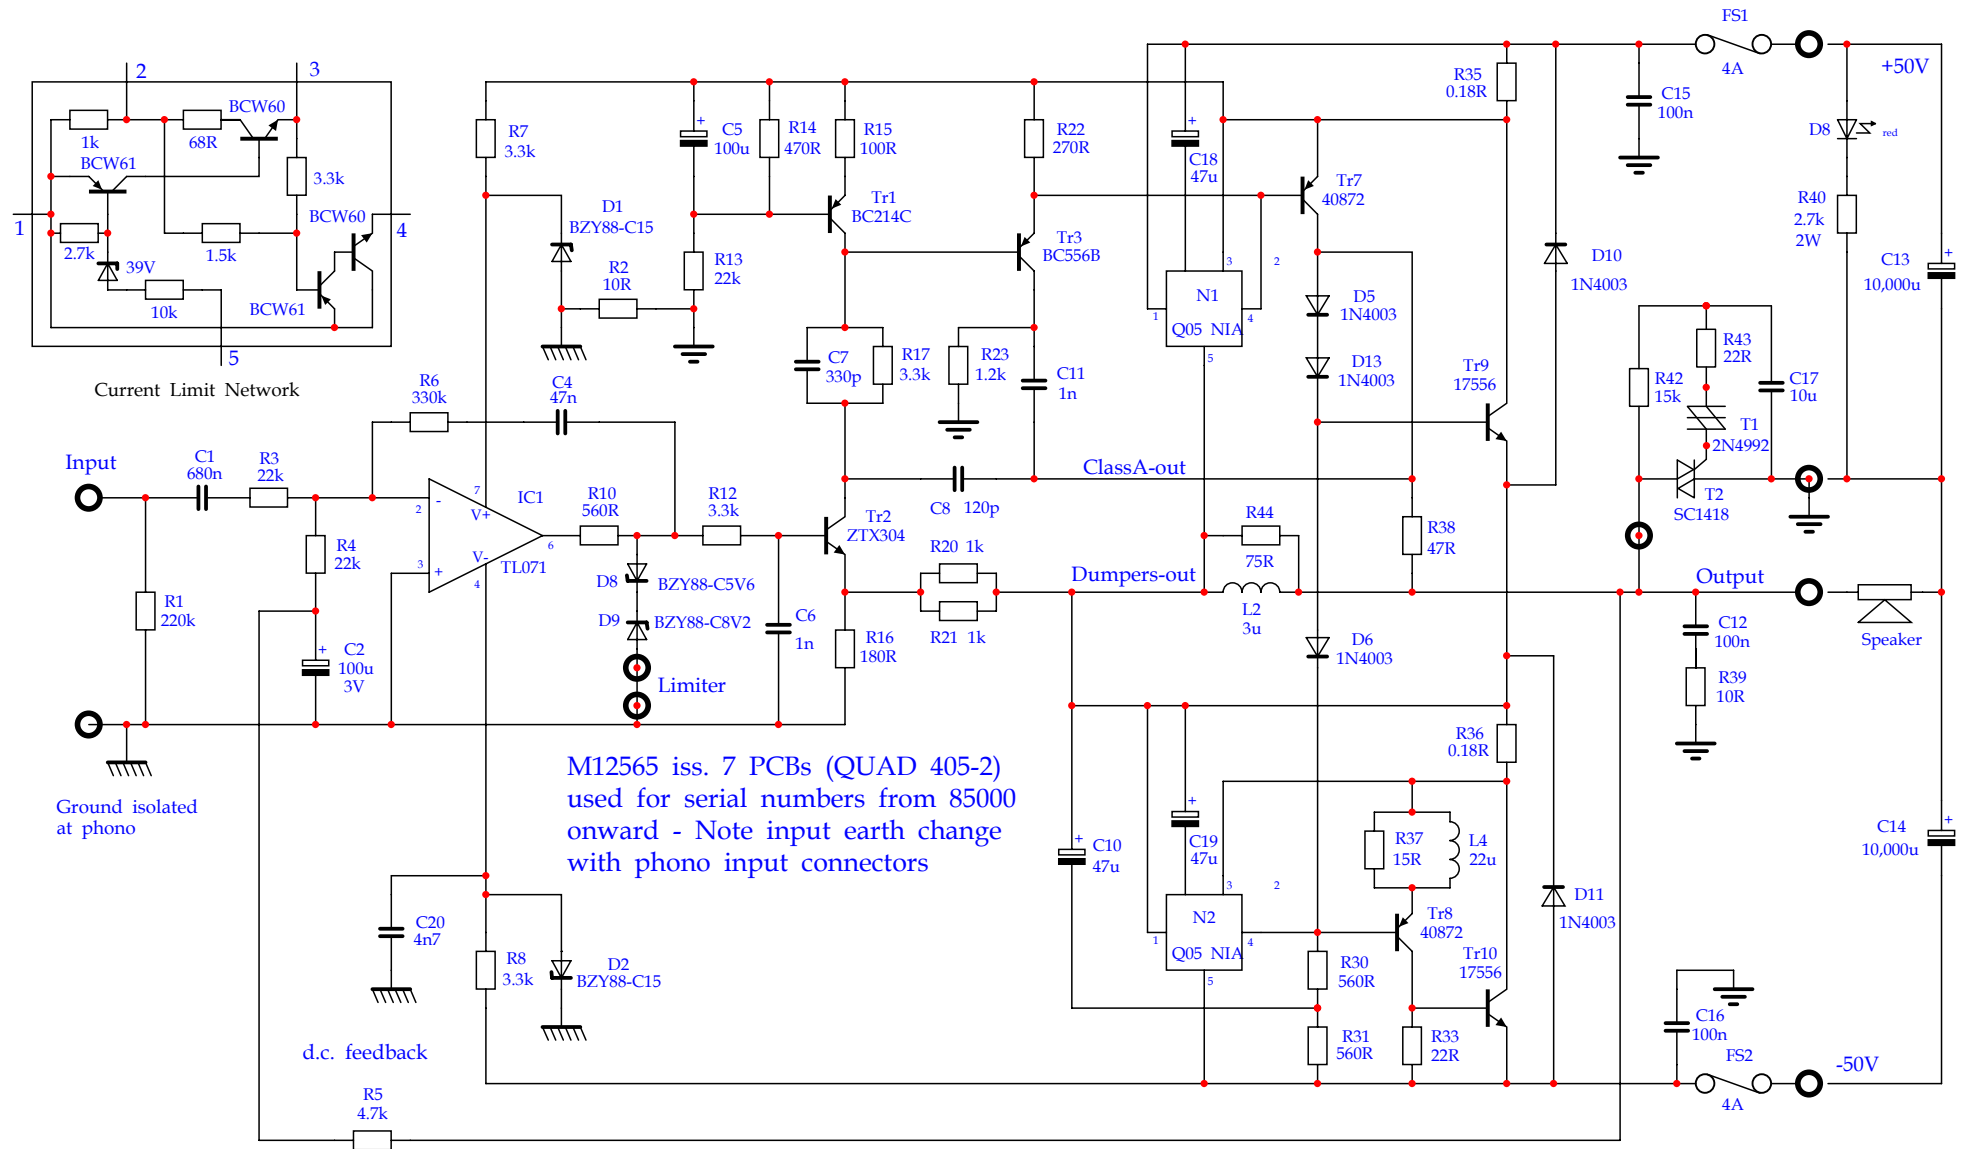

Revision: 3	keith@snook.eu	Page Size: A4
<b>QUAD 405 - M12333 iss. 10</b>		
12 May 2004	Drawn: K. Snook	Checked:
		Page 1of 1

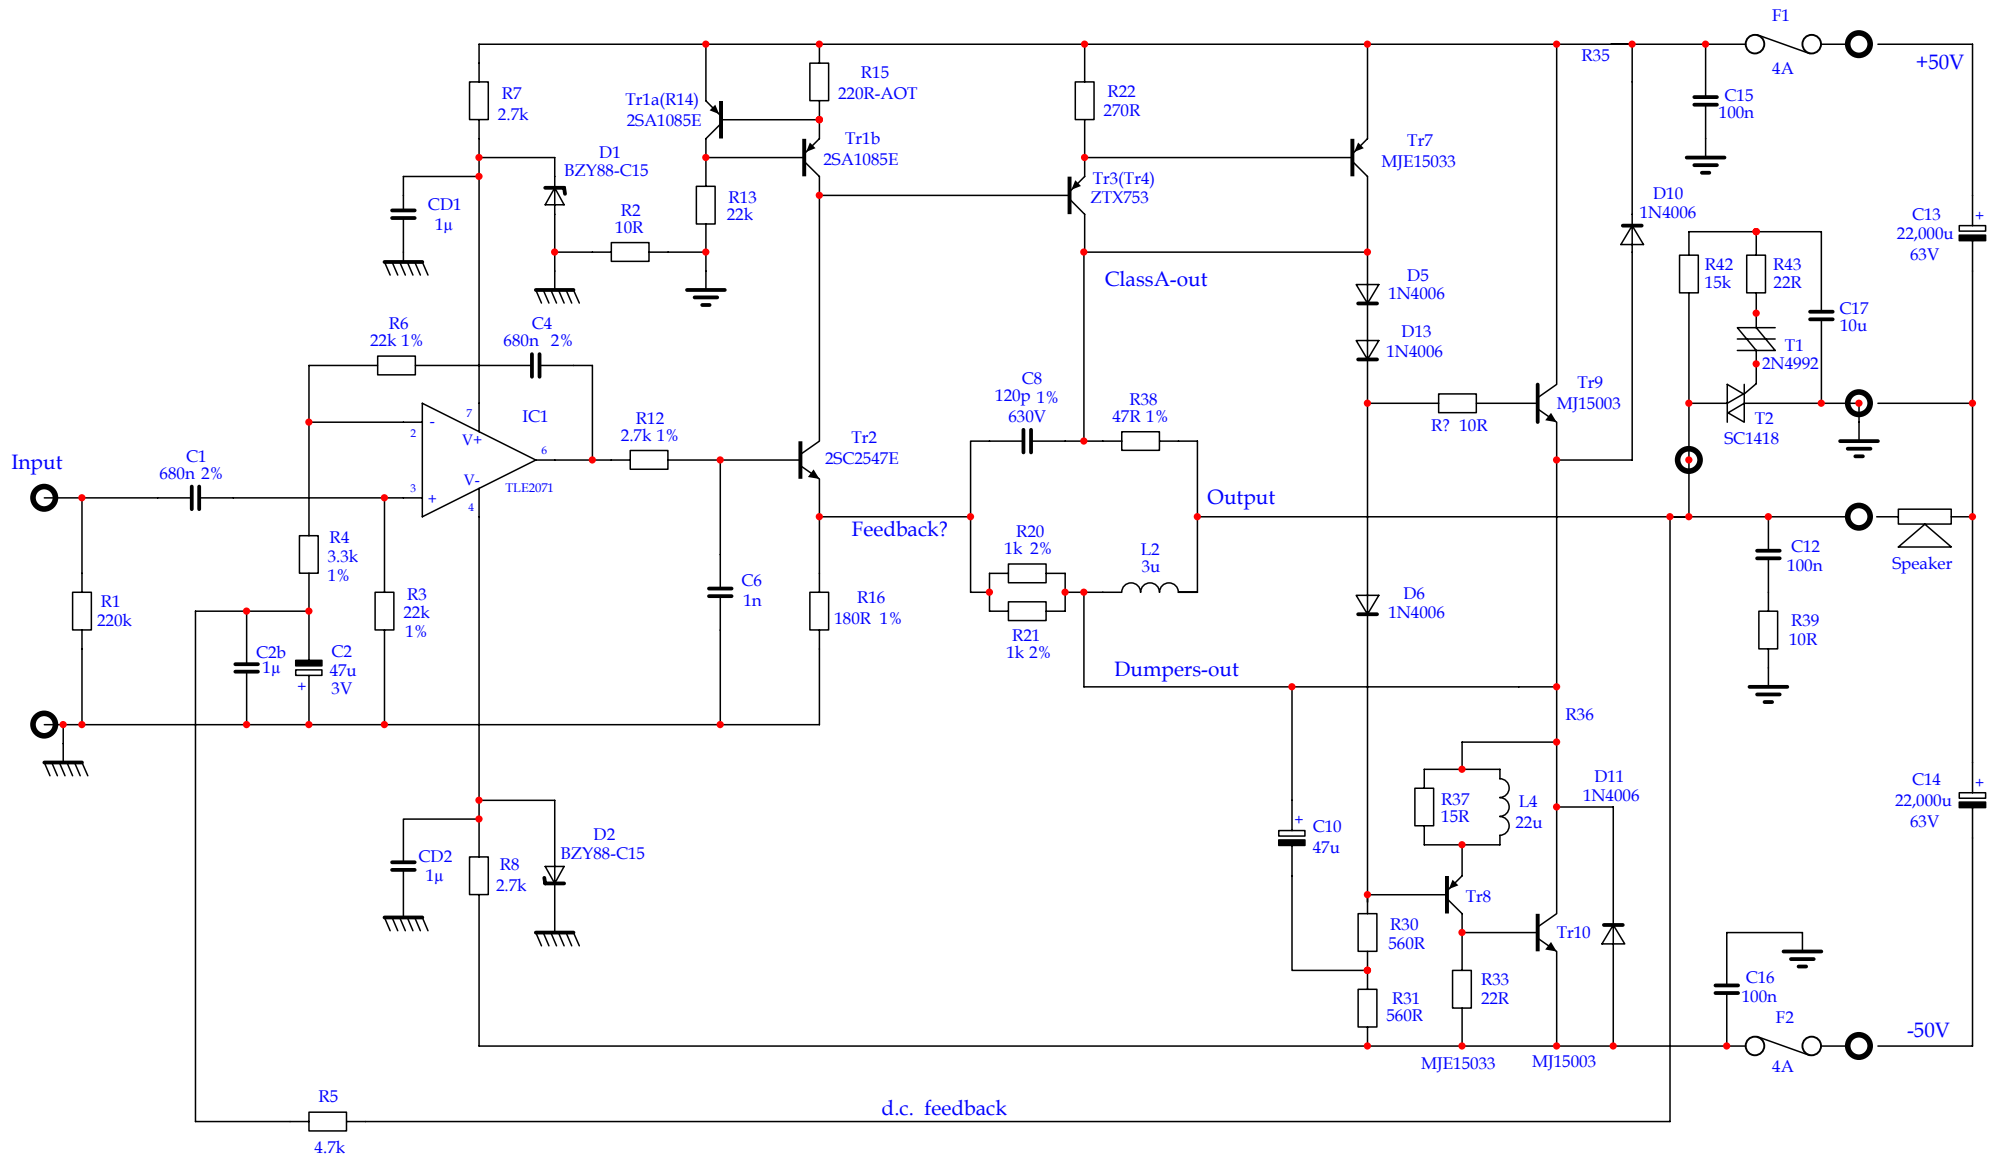

Revision: 6	keith@snook.eu	Page Size: A4
<b>QUAD 405 - DCD Mod-3</b>		
Sept 2011	Drawn: K. Snook	Checked:
		Page 1 of 1

Components marked in green are changes or additions to the original n.f. = not fitted and Link = remove and wire across.


For original sensitivity 0.5V for 100W fit R4 = 1.6k and C2 = 100uF

As shown sensitivity is 1V for 100W

For sensitivity of 1.5V for 100W fit R4 = 4.7k and C2 = 33uF

Tr3 should be bypassed base-emitter as shown and it should then be possible to safely remove C19 fitted across Tr10 collector-base on the solder side of the PCB - If you are not sure bypass Tr3 and leave C19

Components marked in grey with blue reference designators should be removed to disable current limiting - This should be done in conjunction with a change of Tr9 and Tr10 to higher power devices like MJ15003

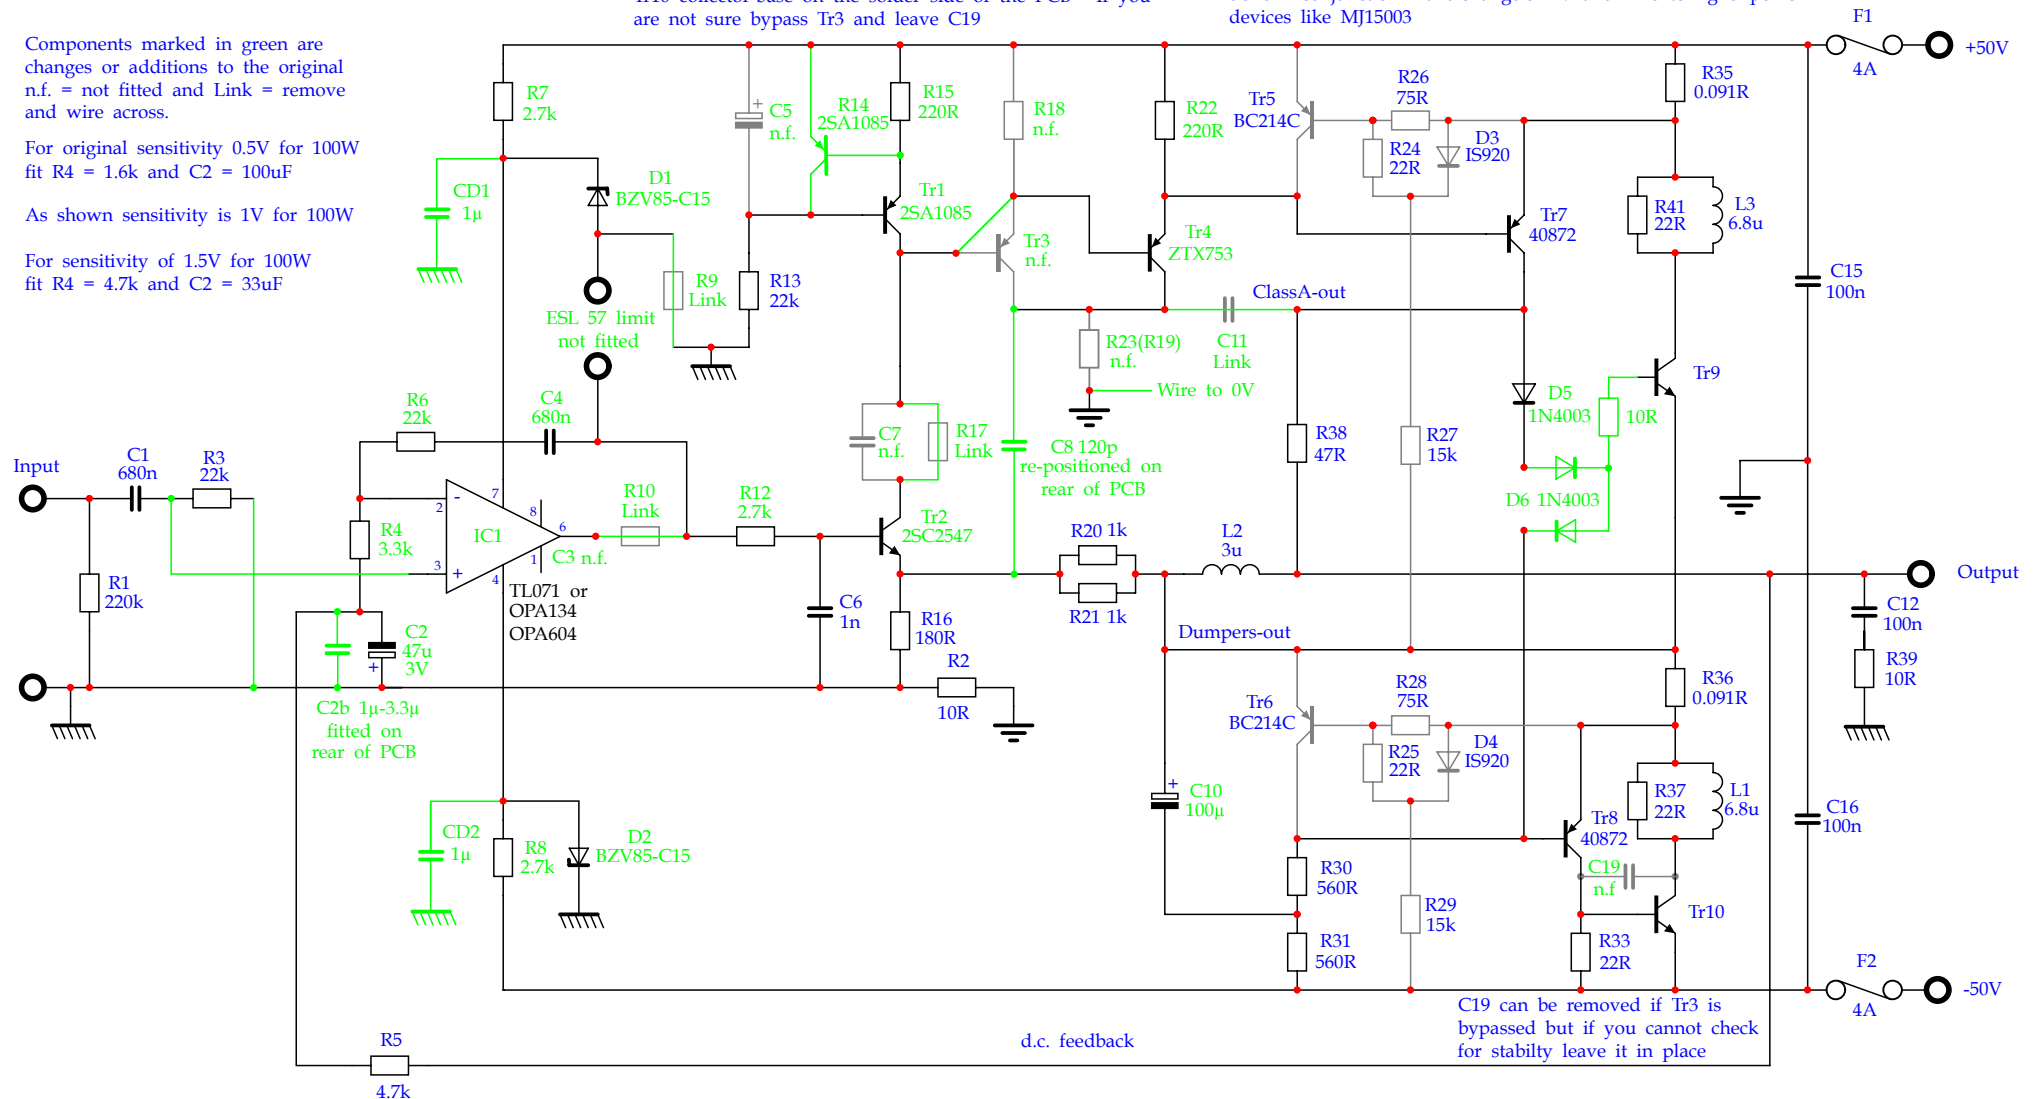


Note the 2 different ground symbols either side of R2 - probably to prevent internal hum loops - The input ground connects to the chassis at the input DIN socket and originally the other side of R2 connects to chassis via the bolt in the heatsink - Even if you do not provide a formal ground wire to the 0V speaker terminal as I show you should ensure that both sides of R2 are at the same potential - If one ground is missing the voltage at the speaker terminals will be about 20mV if both grounds are in place it should be less than 1mV - Both grounds should be connected to chassis

Revision: 3	keith@snook.eu	Page Size: A4
<b>M12368 PCBs to DCD Mod-3</b>		
1 Sept 2008	Drawn: K. Snook	Checked:
		Page 1 of 1

Note: This is only a schematic - It has been implemented as a mod to 12368 iss.10 and 12565 iss.7 PCBs but the circuit can oscillate at VHF radio frequencies which do not appear at the output but can put the transistors in compression - increasing the distortion and dissipation

lookout for updates and refer to my website for further information

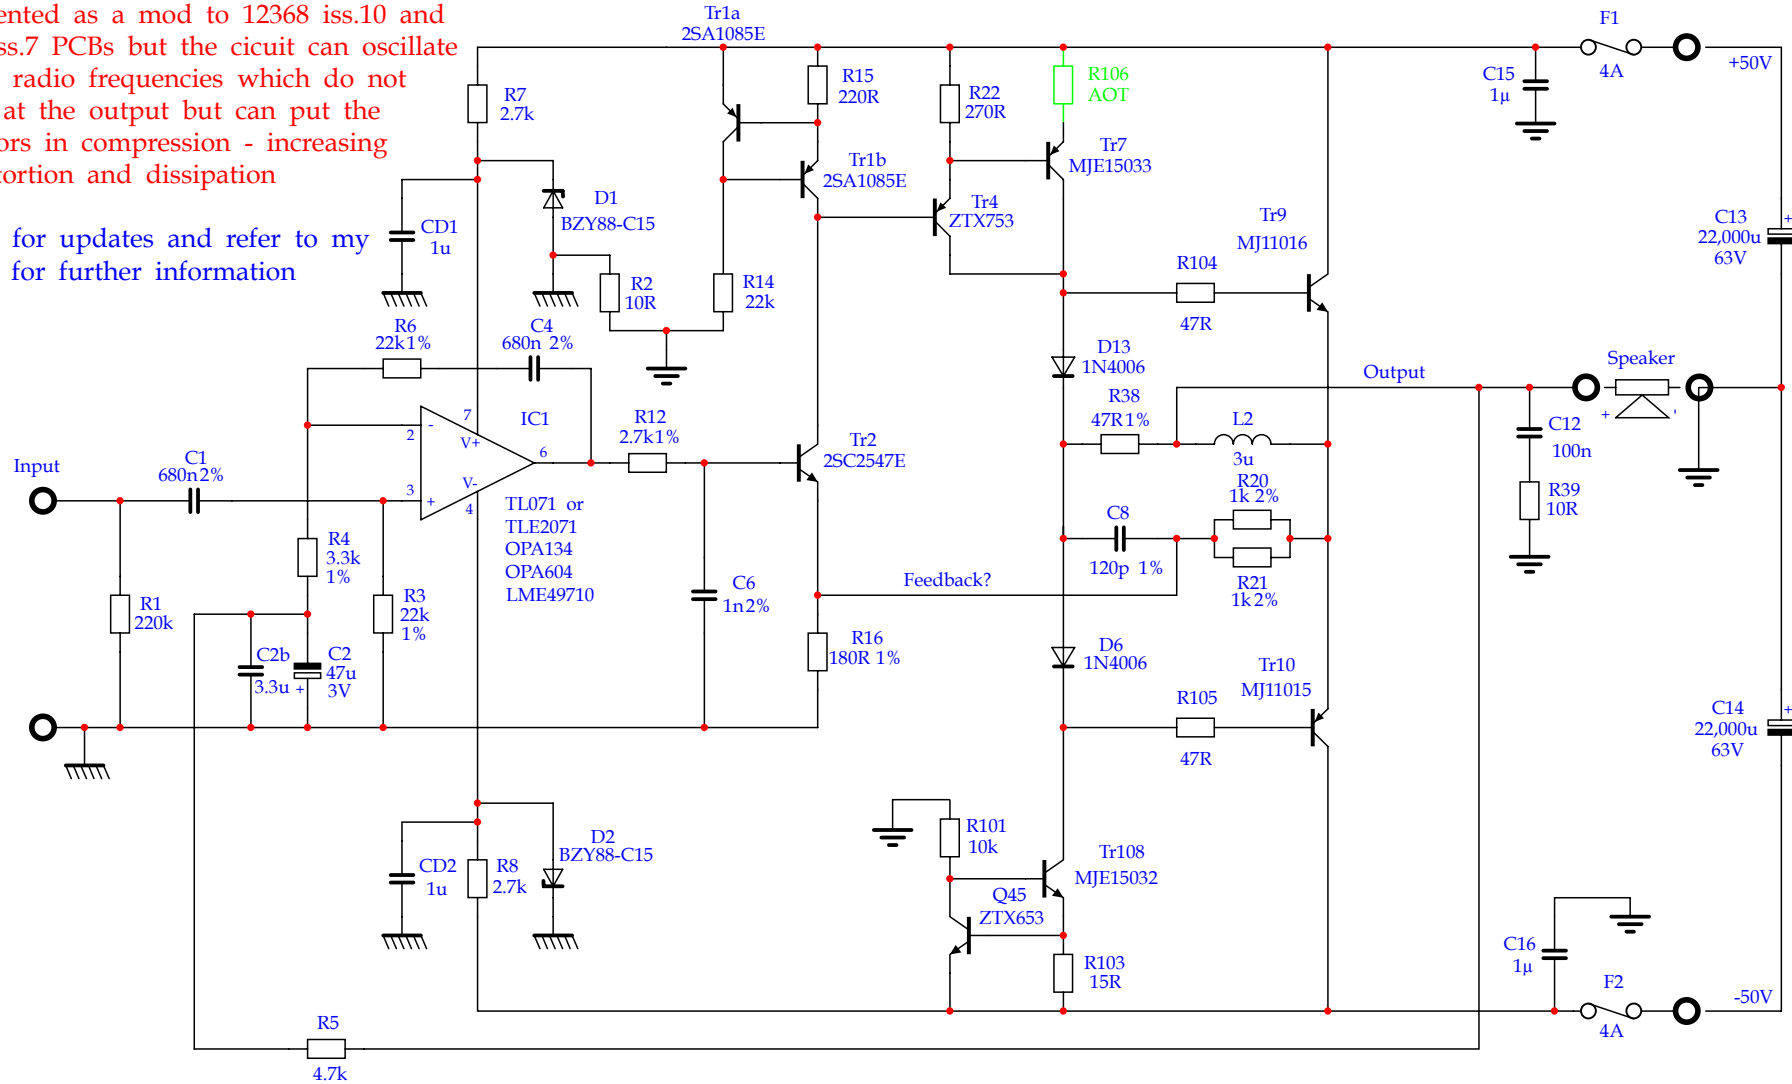

Note: The "Current Dumpers" Tr9 and Tr10 are complimentary Darlington transistors – This layout WILL NOT work with low hfe output devices due to the base current required – The "Current Dumpers" can be made complimentary MOSFETs If D13 and D6 are changed for resistors but care must be taken to ensure that the Source-gate voltage can be obtained within the limits of Tr7 and Tr108 current drive

Revision: 3	keith@snook.eu	Page Size: A4
<b>QUAD 405 - DCD Mod-4</b>		
1 Apr 2005	Drawn: K. Snook	Checked:
		Page 1 of 1